

Row

SCHEDULE 7

FORM OF APPLICATION FOR MODIFICATION ORDER
WILDLIFE AND COUNTRYSIDE ACT 1981

SUFFOLK COUNTY COUNCIL DEFINITIVE MAP
AND STATEMENT FOR PUBLIC RIGHTS OF WAY

PARISH OF Framlingham.....

DISTRICT OF Suffolk Coastal.....

To: The Definitive Map Manager, Rights of Way and Access, Economy, Skills & Environment, Suffolk County Council, Endeavour House, 8 Russell Road, Ipswich, IP1 2BX

I, Luke Wood
of Anglian Historic Paths, Unit 8343, PO Box 6945, London W1A 6US

hereby apply for an order under Section 53 (2) of the Wildlife and Countryside Act 1981 modifying the Definitive Map and Statement for the area by:

~~Deleting/Amending/Adding the *Public Footpath/Bridleway/Restricted Byway/Byway~~

from: College Road (TM 280656)

to: New Road (TM 281196 & TM 281206)

and shown on the map extract annexed hereto.**

I attach copies of the following documentary evidence (including statements of witnesses) in support of this application:

Dated 27th December 2015 Signed L. Wood

* Delete where appropriate

** Include six figure grid references in respect of each end of the public right of way or proposed public right of way or where the route is already recorded on the definitive map the path number. The map to accompany your application should be at a scale of not less than 1:25000.

NOTE: This **Application** form should be returned to the Definitive Map Manager at the above address

SCHEDULE 9

WILDLIFE AND COUNTRYSIDE ACT 1981

SUFFOLK COUNTY COUNCIL DEFINITIVE MAP
AND STATEMENT FOR PUBLIC RIGHTS OF WAY

PARISH OF Framlingham.....

DISTRICT OF Suffolk Coastal.....

CERTIFICATE OF SERVICE OF NOTICE OF APPLICATION
FOR MODIFICATION ORDER

To: The Definitive Map Manager, Rights of Way and Access, Economy, Skills & Environment, Suffolk County Council, Endeavour House, 8 Russell Road, Ipswich, IP1 2BX

I, Luke Wood
of Anglian Historic Paths, Unit 8343, PO Box 6945,
London W1A 6US

hereby certify that the requirements of paragraph 2 of Schedule 14 to the Wildlife and Countryside Act 1981 have been complied with and that the following people have been served with a Notice under Schedule 8:


<u>Name</u>	<u>Address</u>
<u>Mrs Helen Alcoe</u>	<u>Framlingham College, IP13 9EY</u>

Dated this 27th day of December 20 15

Signed L. Wood

NOTE:
The Wildlife and Countryside Act 1981 requires an applicant for a Modification Order to serve notice of the application on every owner and occupier of any land affected by the claimed route. Where it is not possible to identify the landowner or occupier the applicant may (on direction of the County Council) address the notice 'to the owner or occupier' and fix it to a post or a conspicuous object on the land. The applicant must then complete this Schedule 9 Certificate to certify to Suffolk County Council that these requirements have been satisfied.

This Certificate should be returned to The Definitive Map Manager at the above address with the Schedule 7 Application form.

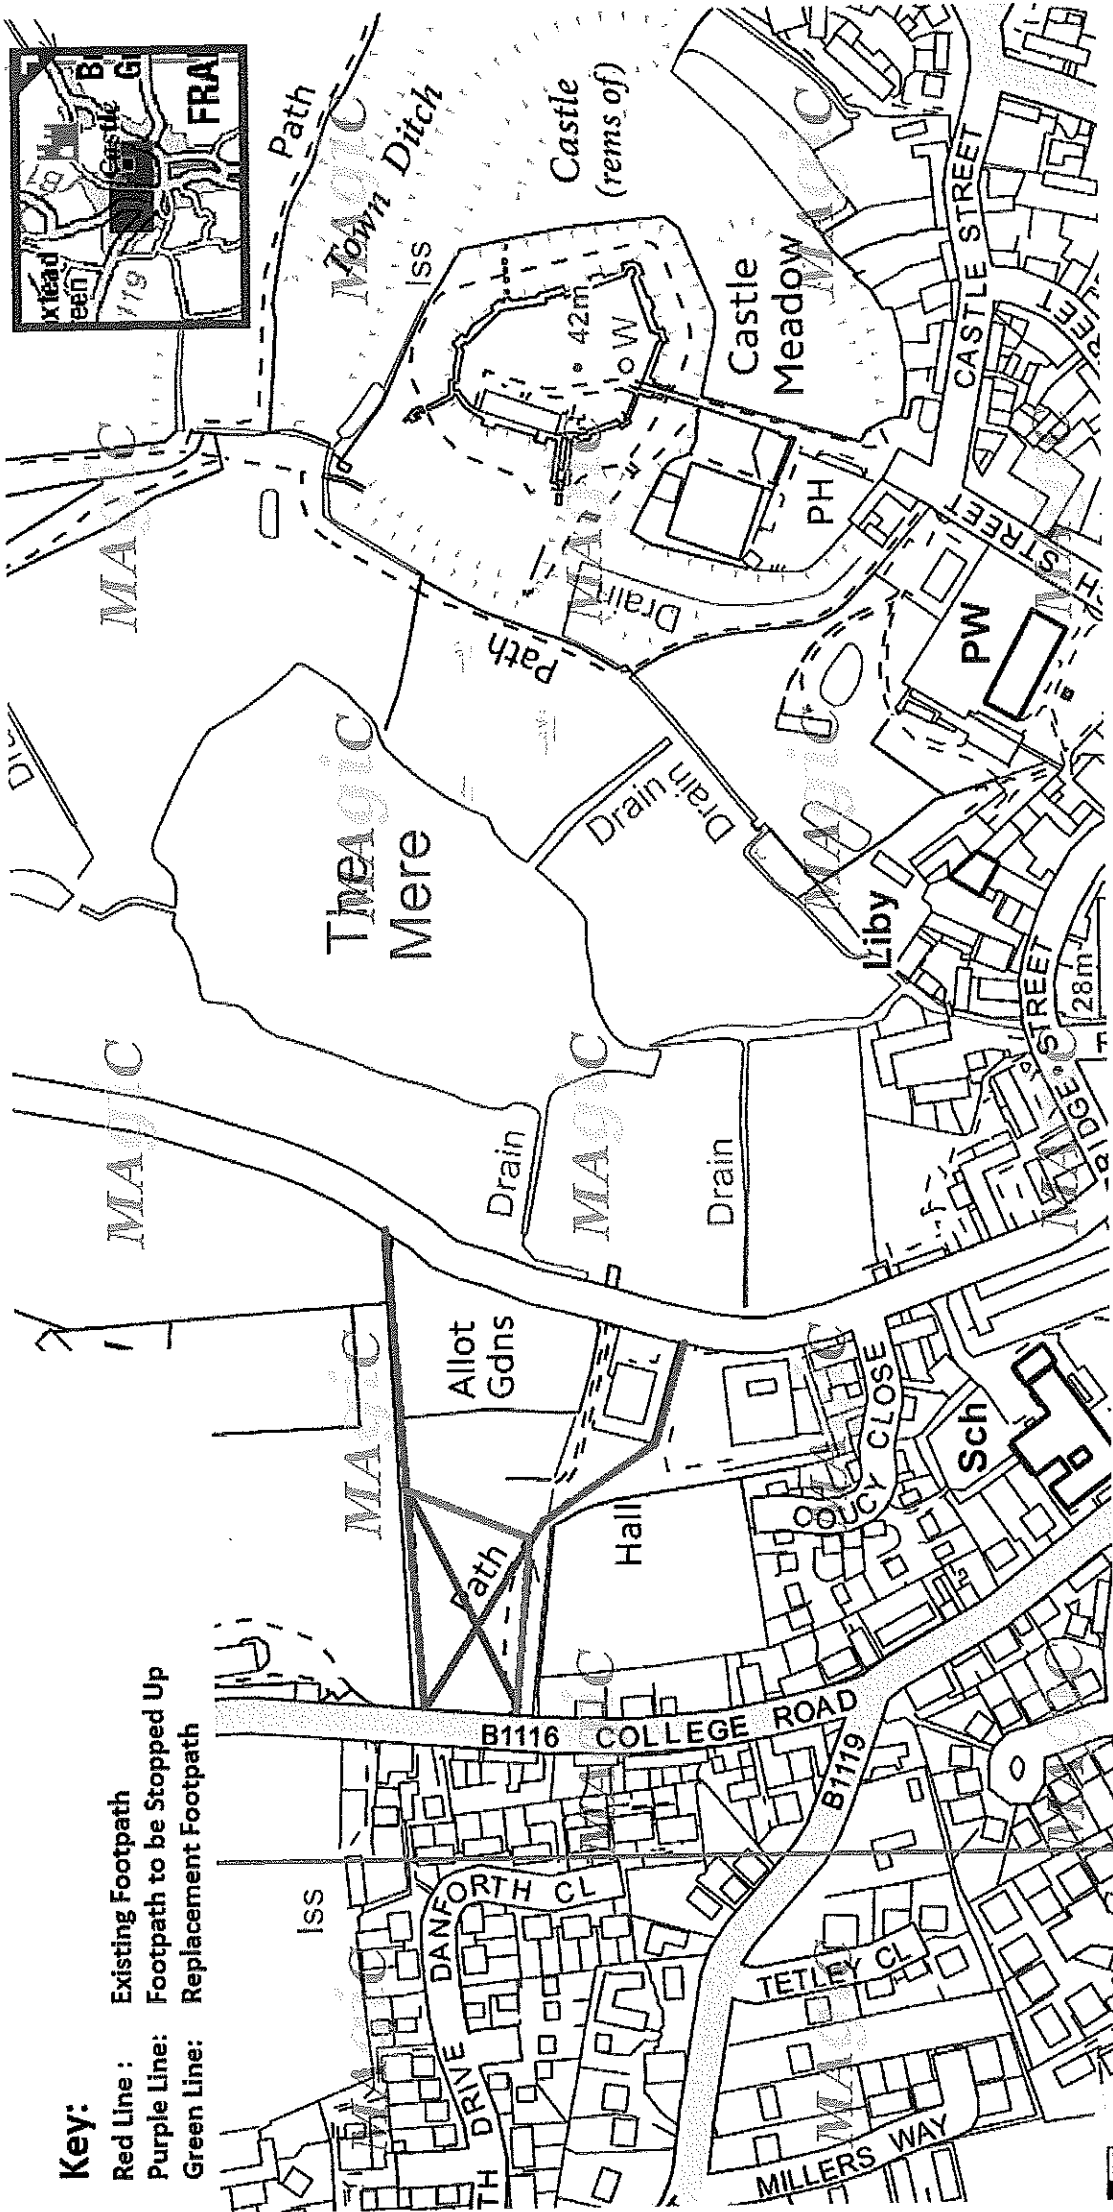

Key:

- Red Line : Existing Footpath
- Purple Line: Footpath to be Stopped Up
- Green Line: Replacement Footpath